


BYERS ROAD BUILDING SECOND FLOOR AS BUILT

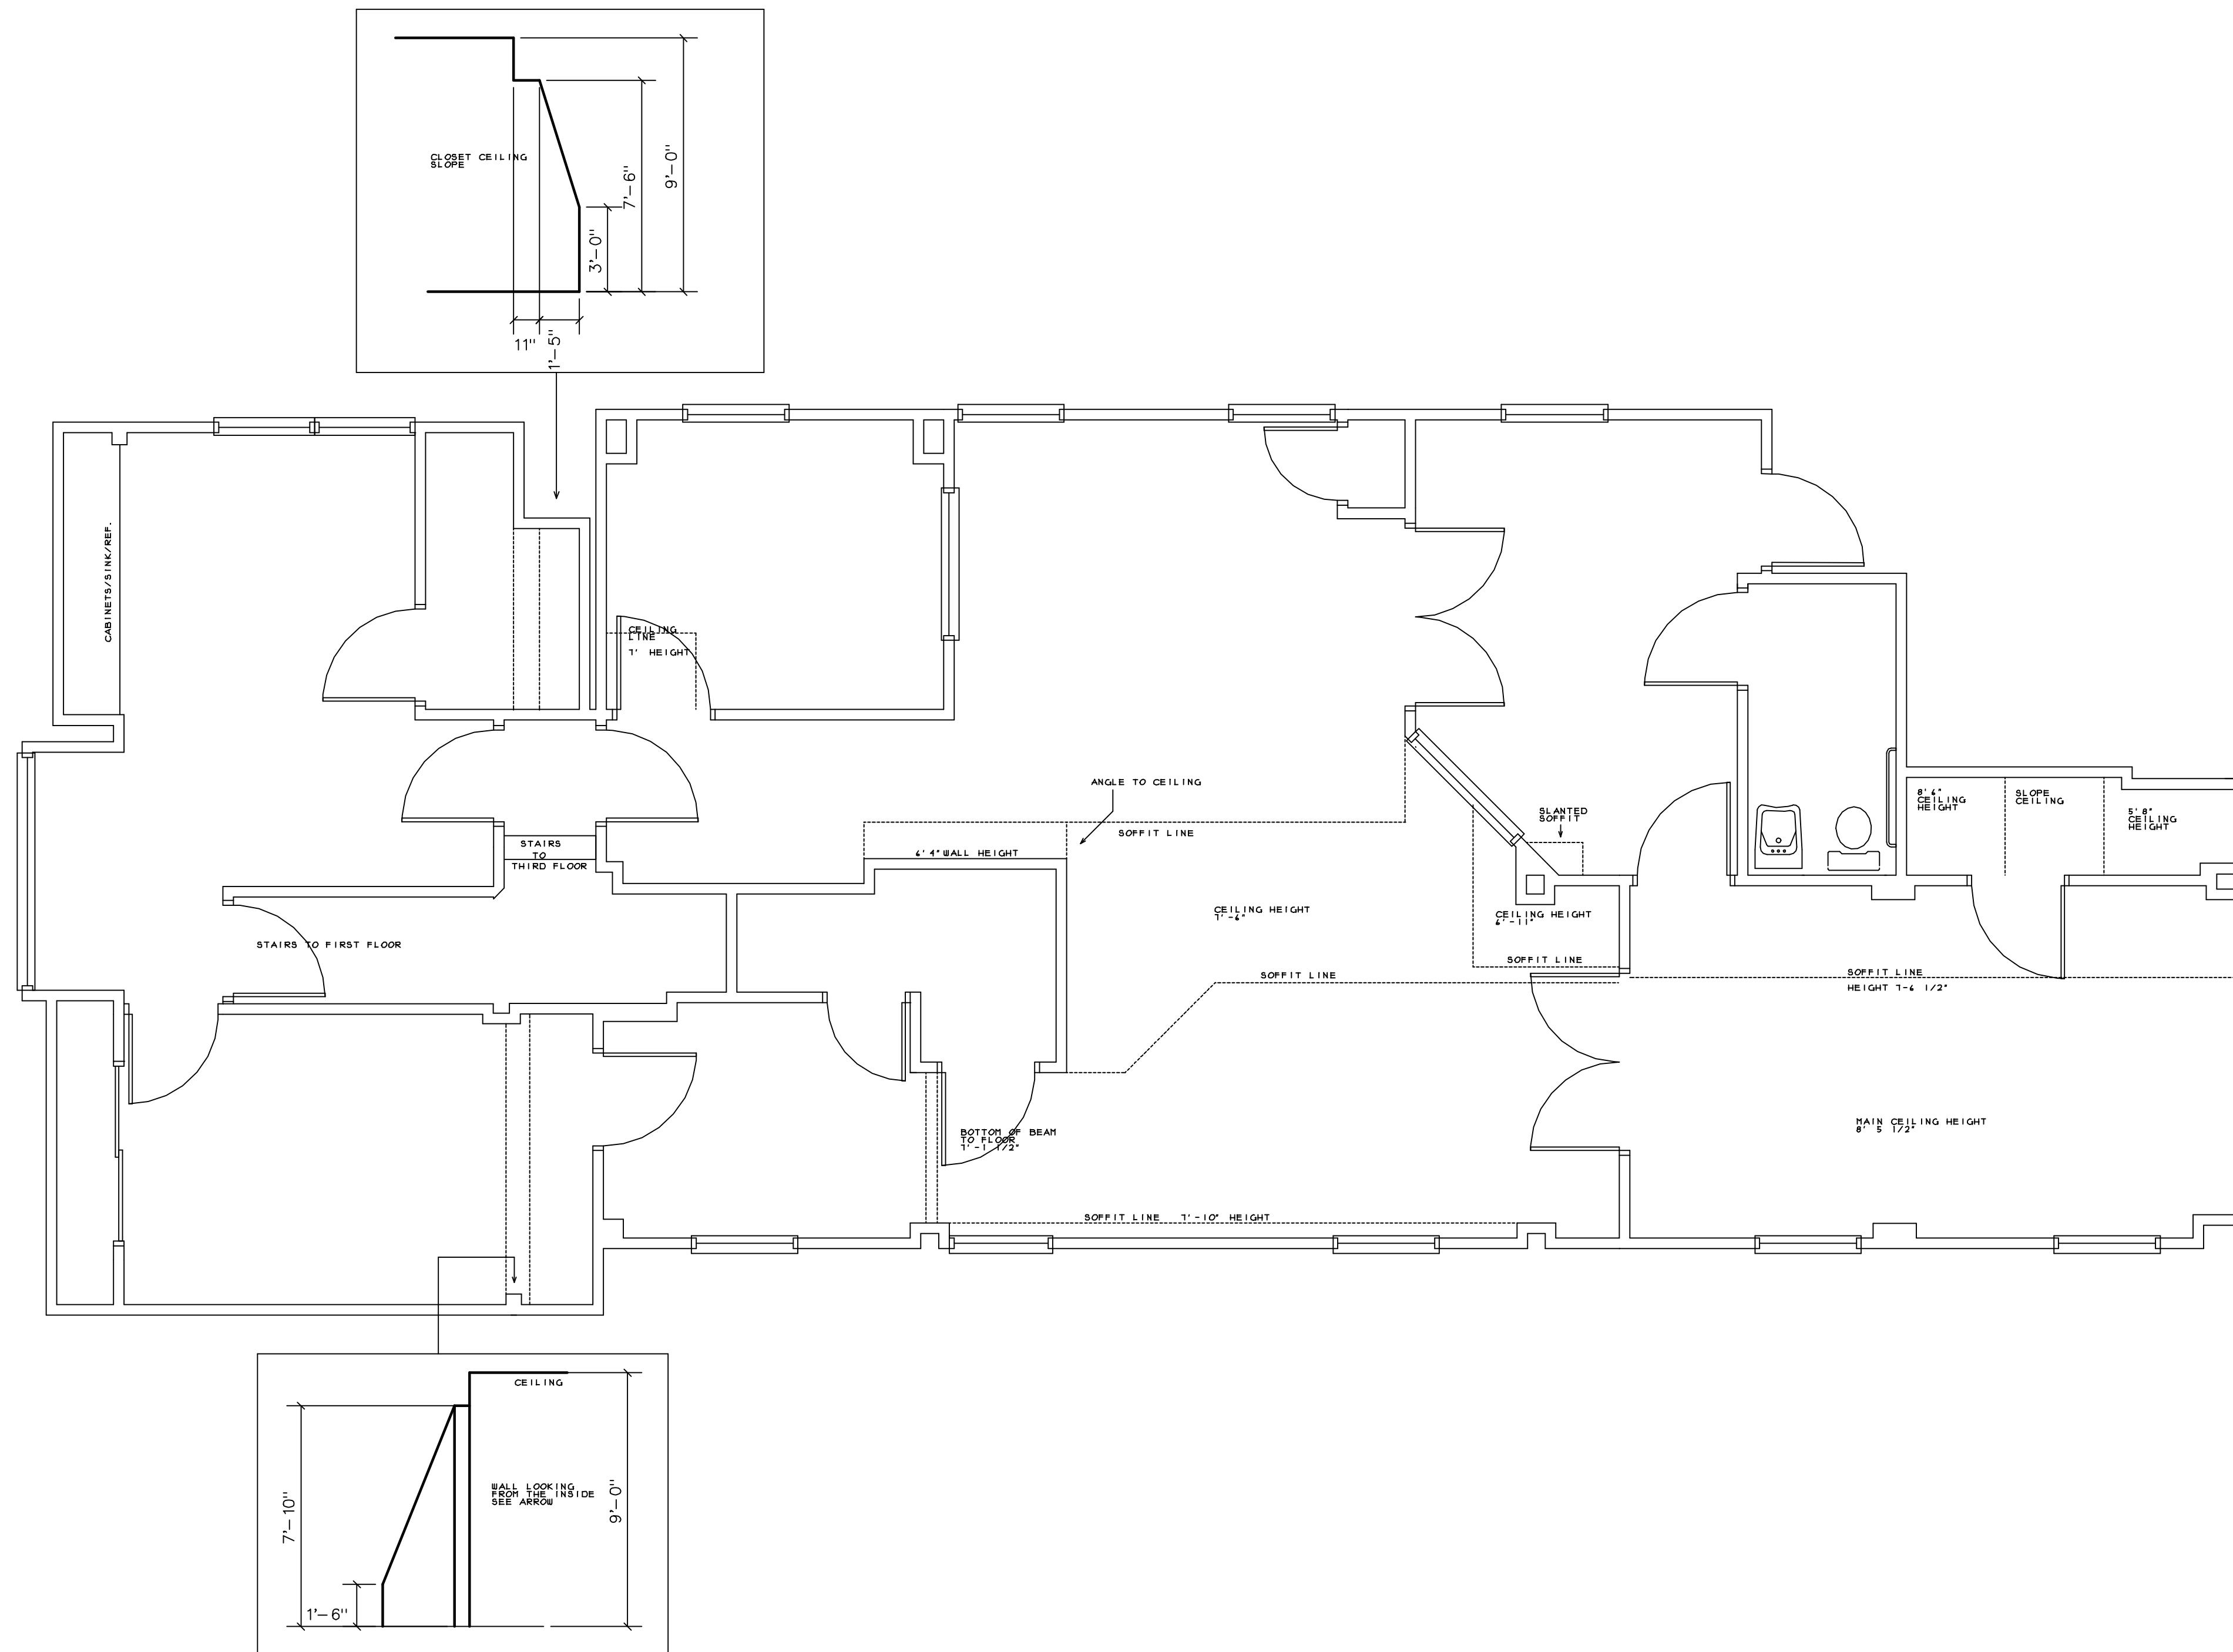

J AND ENTERPRISES, INC.
126 ASPEN DRIVE
DOWNTOWN, PA. 19335
610-942-3422

CLAMPUS & RETO
VISIONS ASSOCIATES, P. C.

Project # 82803
Date 8-28-03
Designed by AA
Drawn by AA
Checked by AA
Revised

Sheet No.
A-1